

ALL DRAWINGS TO BE READ IN CONJUNCTION WITH ALL OTHER RELEVANT DRAWINGS, TOGETHER WITH THE SPECIFICATIONS

ALL DETAIL DIMENSIONS ARE IN MILLIMETERS AND LAYOUT DIMENSIONS AND LEVELS IN METERS UNLESS OTHERWISE STATED

DIMENSIONS AND LEVELS ARE TO FINISHED SURFACES


THE CONTRACTOR SHALL BE RESPONSIBLE FOR PRODUCING A COMPLETE SET OF COORDINATED SHOP DRAWINGS FOR ALL ELEMENTS OF THE WORK FOR CONSULTANT'S APPROVAL, PRIOR TO THE COMMENCEMENT OF THE WORKS

CONTRACTOR TO PRODUCE A REPRESENTATIVE SAMPLE FOR CONSULTANT'S APPROVAL FOR EACH ELEMENT, TO WHICH THE WORKS ON SITE MUST CONFORM

THE CONTRACTOR SHALL MAKE HIMSELF FULLY AWARE OF THE SITE CONDITIONS, EXISTING GROUND WATER LEVELS, NECESSITY FOR BACK PROPPING EXCAVATED AREAS AND EXISTING SERVICES

ALL CONCRETE STRUCTURES/REINFORCEMENT AS PER STRUCTURAL SPECIFICATION

⊗ MARK TO BE THE REFERENCE LEVEL (BOTTOM OF KERB)

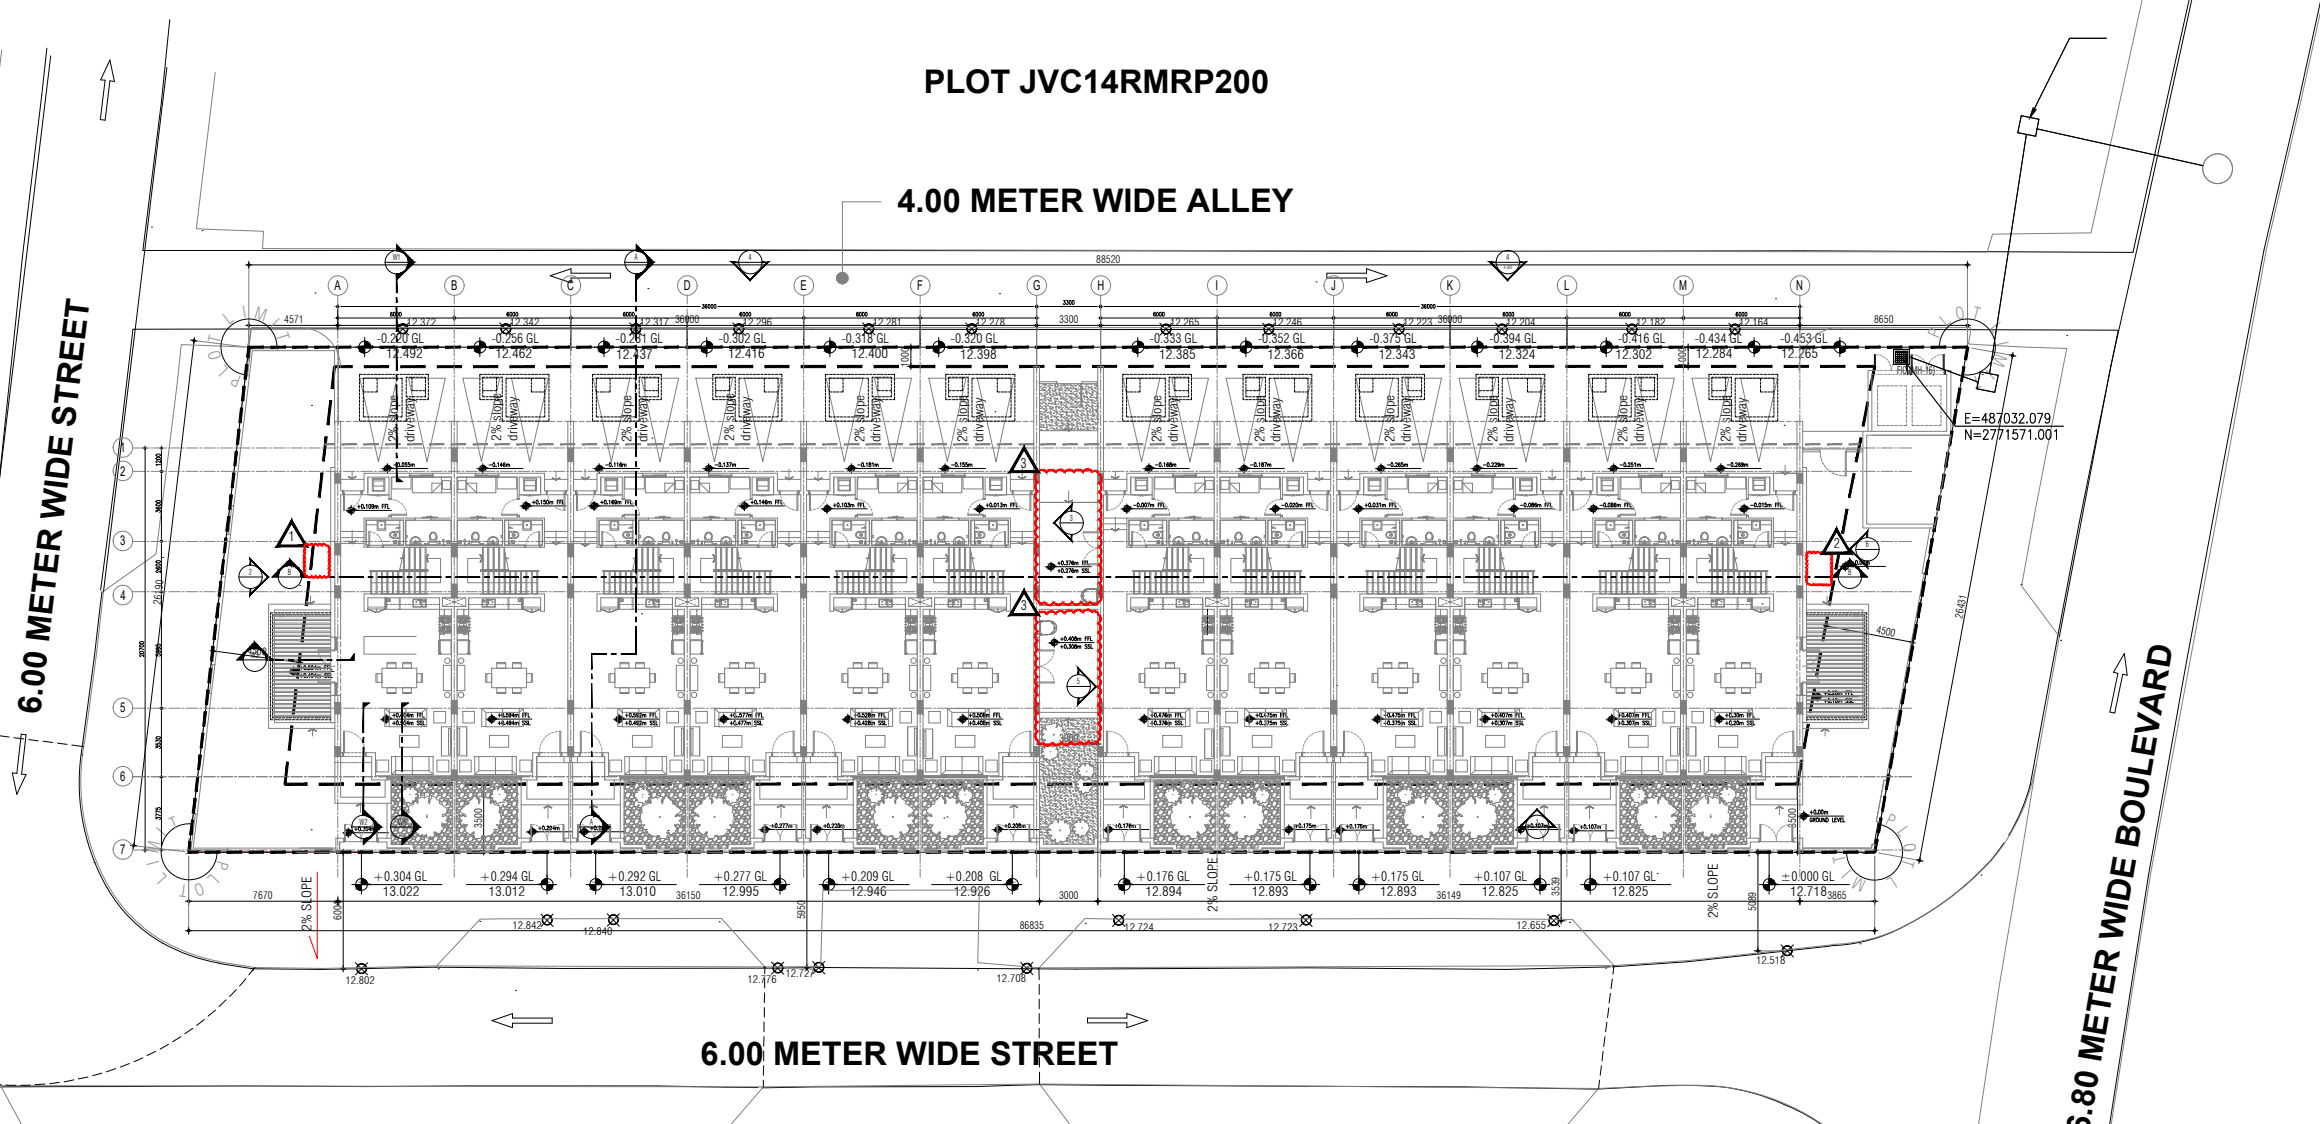

**1** **GROUND FLOOR PLAN**  
SCALE 1:200

REV.	DATE	DESCRIPTION
A0	NOV 2019	ISSUED FOR APPROVAL

STAMP

LEGEND:

1	CAT LADDER MOVED TO VILLA 6
2	CAT LADDER MOVED TO VILLA 7
3	PERGOLA REMOVED BETWEEN VILLA 6 & 7

**AS BUILT**

CLIENT: AE JV ALPHA PROJECT LIMITED

CONSULTANT:  
**A N T ENGINEERING CONSULTANT**  
P O BOX 232606, DUBAI  
TEL: ( 04 ) 2838490  
TEL: ( 04 ) 2838490

MAIN CONTRACTOR:  
**K & D International Contracting LLC**  
TEL No: +971 4 443 1726 FAX No: +971 4 443 1728  
e-mail: info@kdi-mena.com

PROJECT:  
G+2 TOWNHOUSES  
PLOT-JVC14RFRP003  
JUMEIRAH VILLAGE CIRCLE, DUBAI, UAE

DRAWING TITLE:  
SITE PLAN @ GROUND FLOOR LEVEL

SCALE:	1:200
DATE:	NOVEMBER 2019
DESIGNED BY:	
DRAWN BY:	NEO A.
PROJECT NO :	JVC14RFRP003
DRAWING NO :	2956/109-AR-SFG-ABD-A-004
REV:	PAGE: 03

CONTRACTING COMPANIES MUST CONTROL DIMENSIONS AND LEVELS ON SITE AND MUST REPORT ANY FAULT TO THE PROJECT DIRECTION.

