

**KEY PLAN**

**VILLAS**

CODE A APPROVED  
 CODE B APPROVED AS NOTED  
 CODE C REVIEWED AS DATED RE-SUBMIT  
 CODE D NOT REQUIRED  
 CODE E NOT APPROVED  
 CODE F NOT APPROVED  
 CODE G NOT APPROVED  
 CODE H NOT APPROVED  
 CODE I NOT APPROVED

DRAWN BY: [Signature]  
 CHECKED BY: [Signature]  
 DATE: [Signature]

**AS BUILT**

No.	Date	By	Revision Details
00	27-06-2019	SA	First Submission

**REVISIONS**

**PROJECT**

PA-27 SIDRA-1,  
512-VILLAS  
DUBAI HILLS ESTATE  
DUBAI, UAE

**CLIENT**

DUBAI HILLS  
ESTATE LLC  
P.O. BOX 9440  
DUBAI, UAE

**MAIN CONSULTANT**

bhans  
BHNS Engineering  
Consultants  
P.O. BOX 281  
DUBAI, UAE


**MAIN CONTRACTOR**

GINCO  
GENERAL CONTRACTOR  
P.O. BOX 100000  
DUBAI, UAE


**DRAWING TITLE**

VILLA E5  
FLOOR PLANS

Status	Drawn By	Checked By	Date
File Ref.	S.A	Eng. Ab. Baham	JUNE 2018
Project No.	Drawing No.	Scale	Revision
-	<b>A1-01</b>	1:100m	00

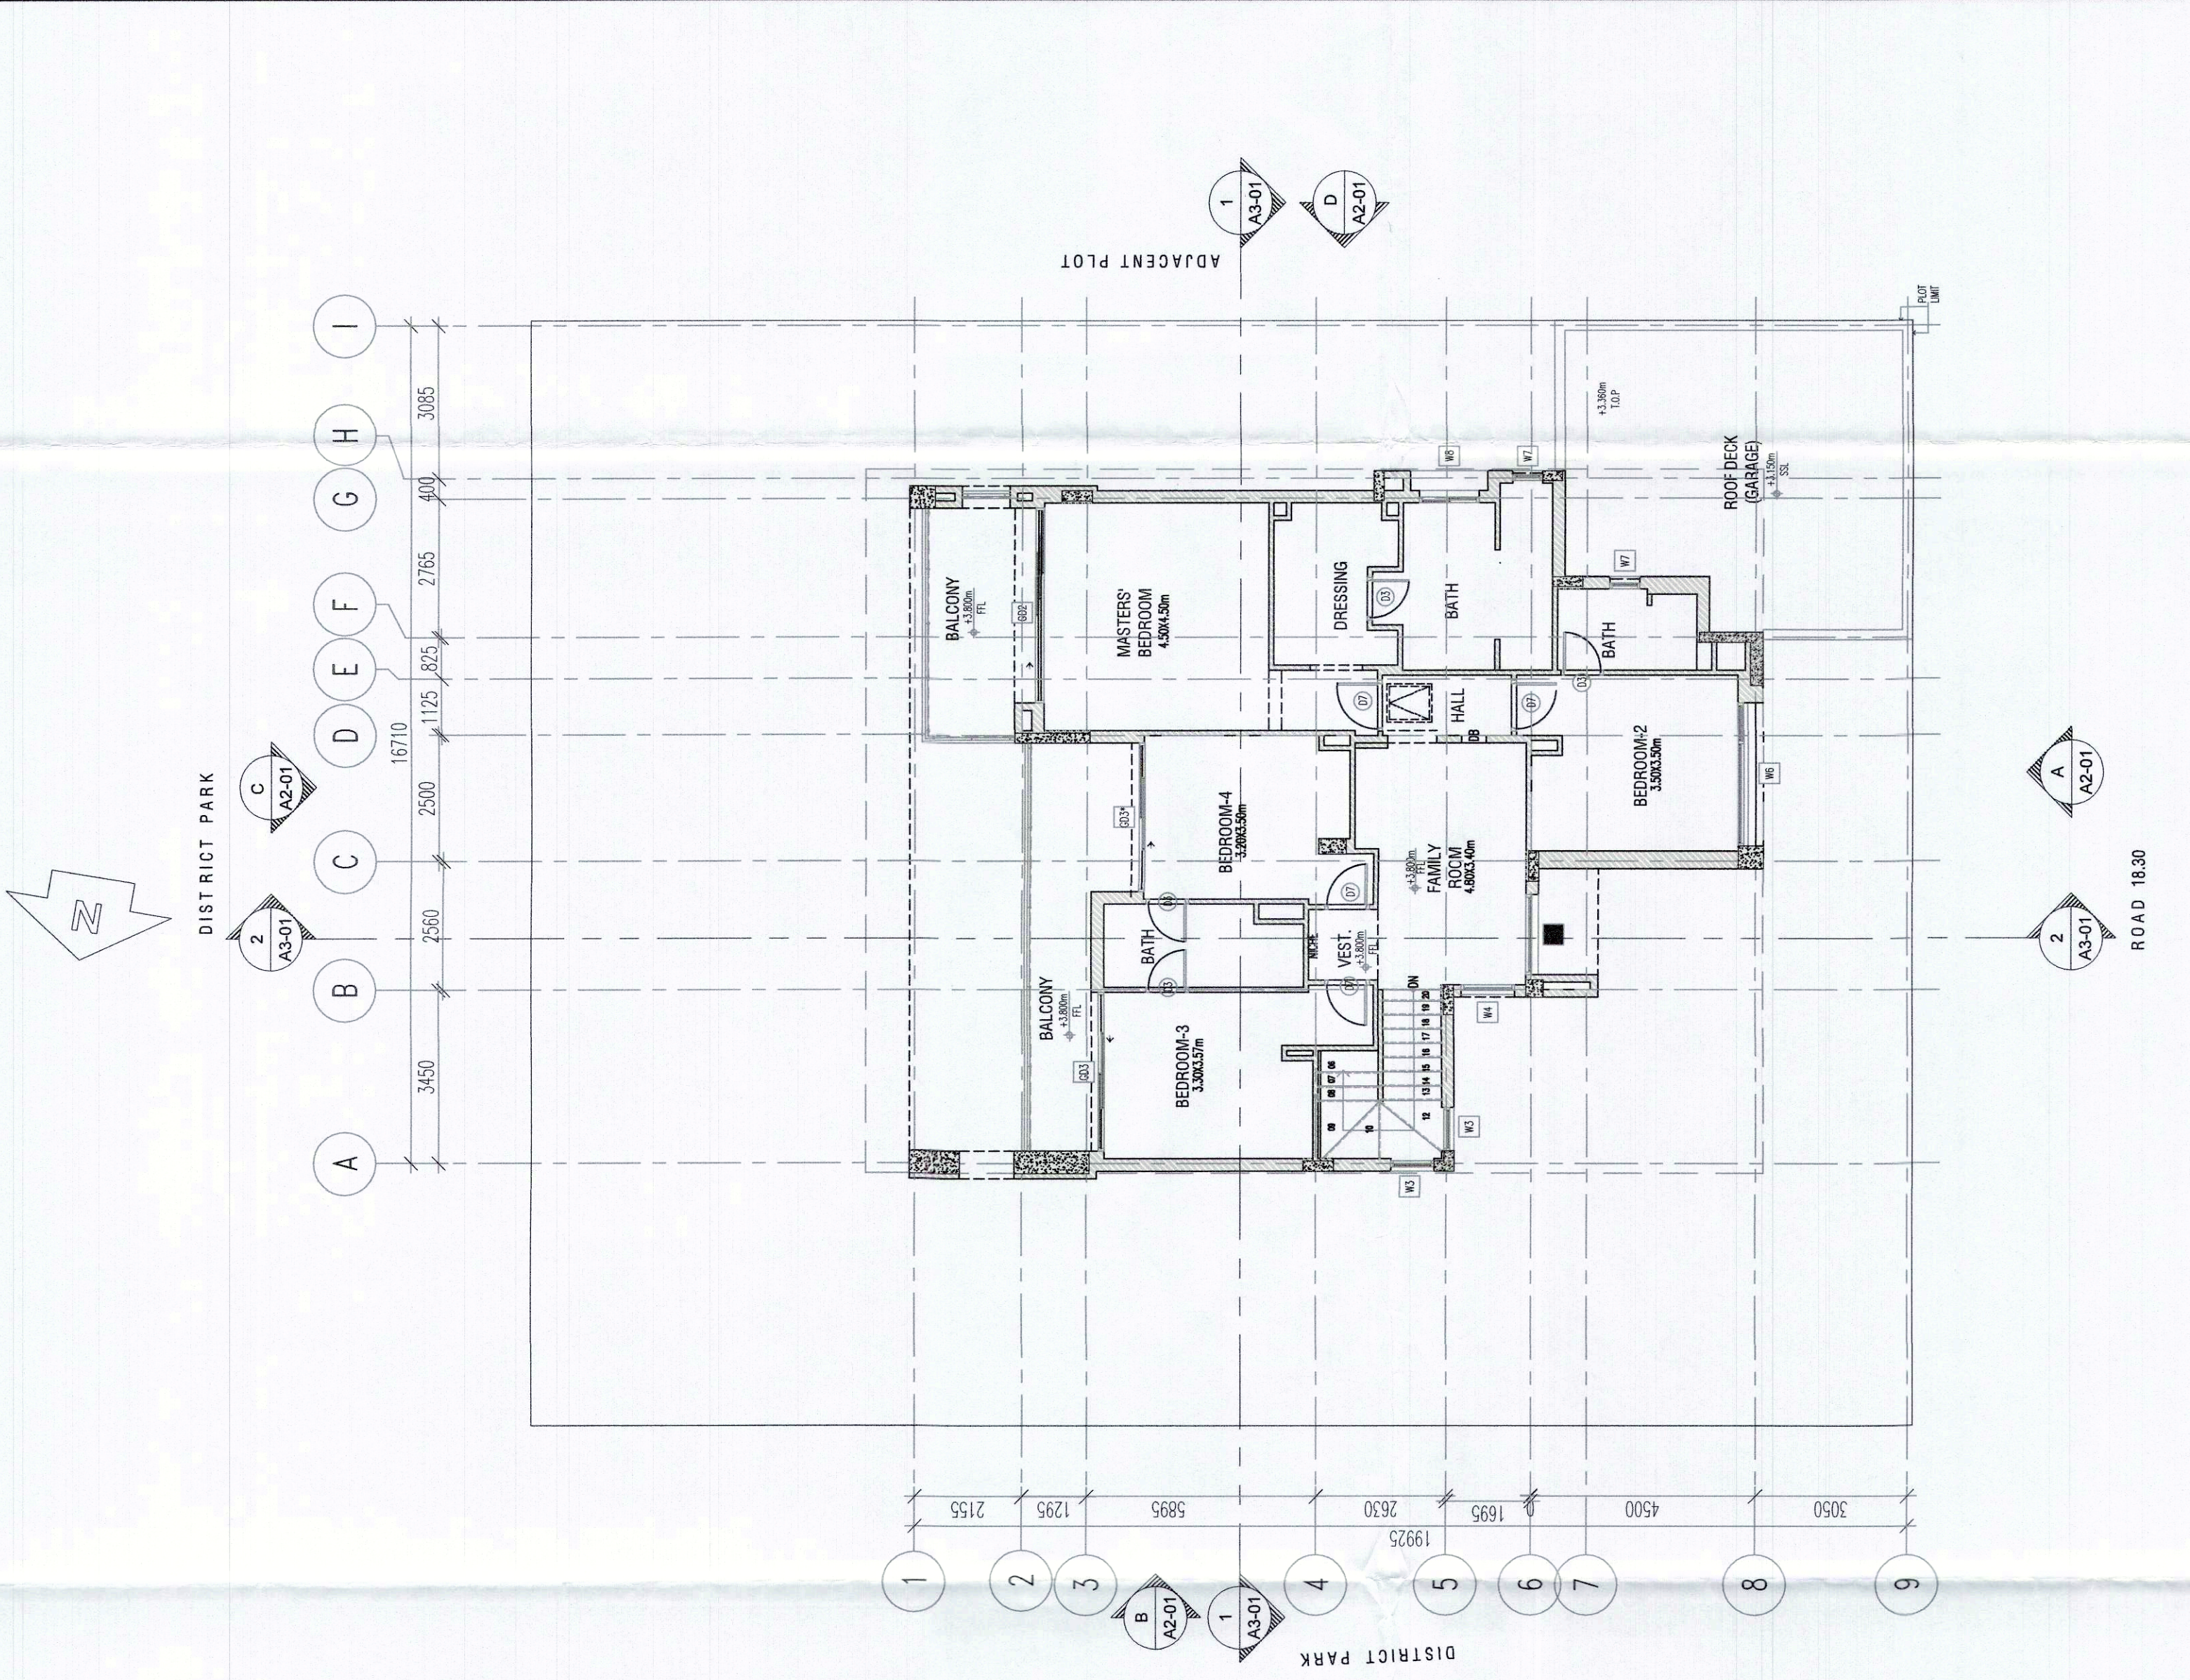

**B 1ST FLOOR PLAN**  
SCALE 1:100m

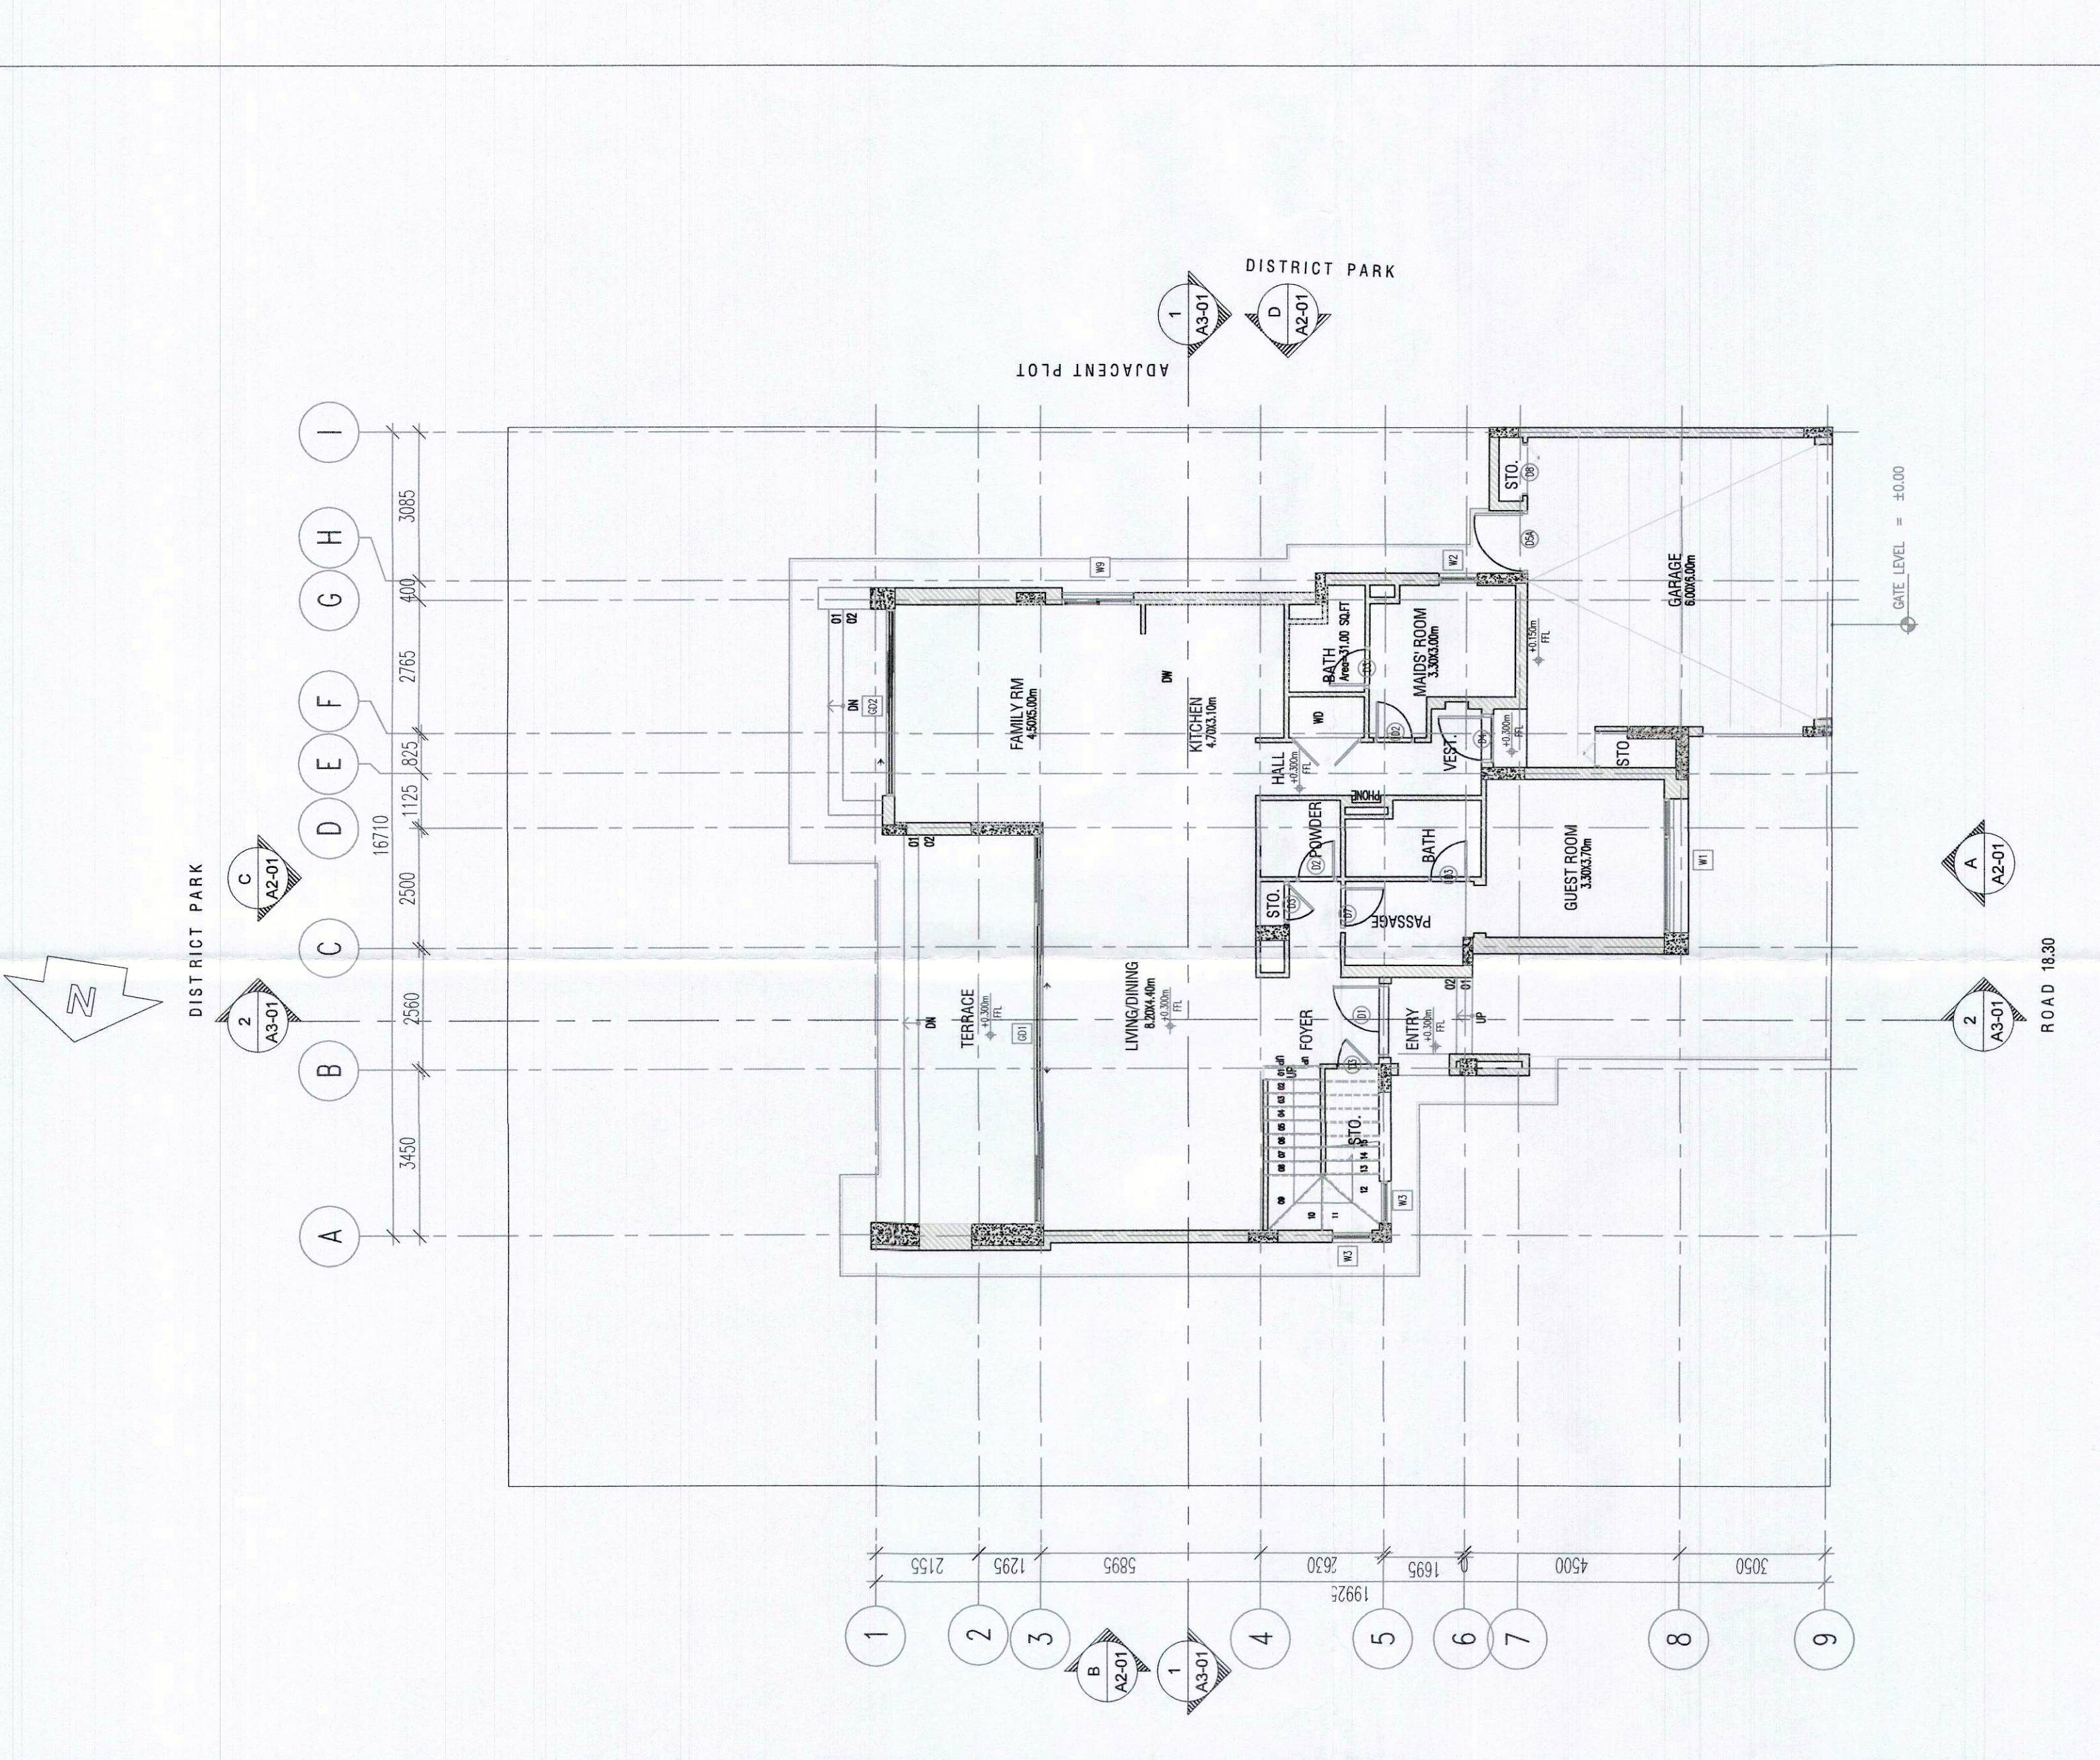

**A GROUND FLOOR PLAN**  
SCALE 1:100m